


STREETLIGHT POLE AND FIXTURE SCHEDULE

| POLE NUMBER | POLE TYPE, COLOR, HEIGHT  | CCT   |
|-------------|---------------------------|-------|
| CLD3203N    | 16' DOUBLE CARLYLE, BLACK | 3000K |
| CLD3204N    | 16' DOUBLE CARLYLE, BLACK | 3000K |
|             |                           |       |
|             |                           |       |
|             |                           |       |
|             |                           |       |

CONTRACTOR NAME  
DATE OF FINAL INSPECTION

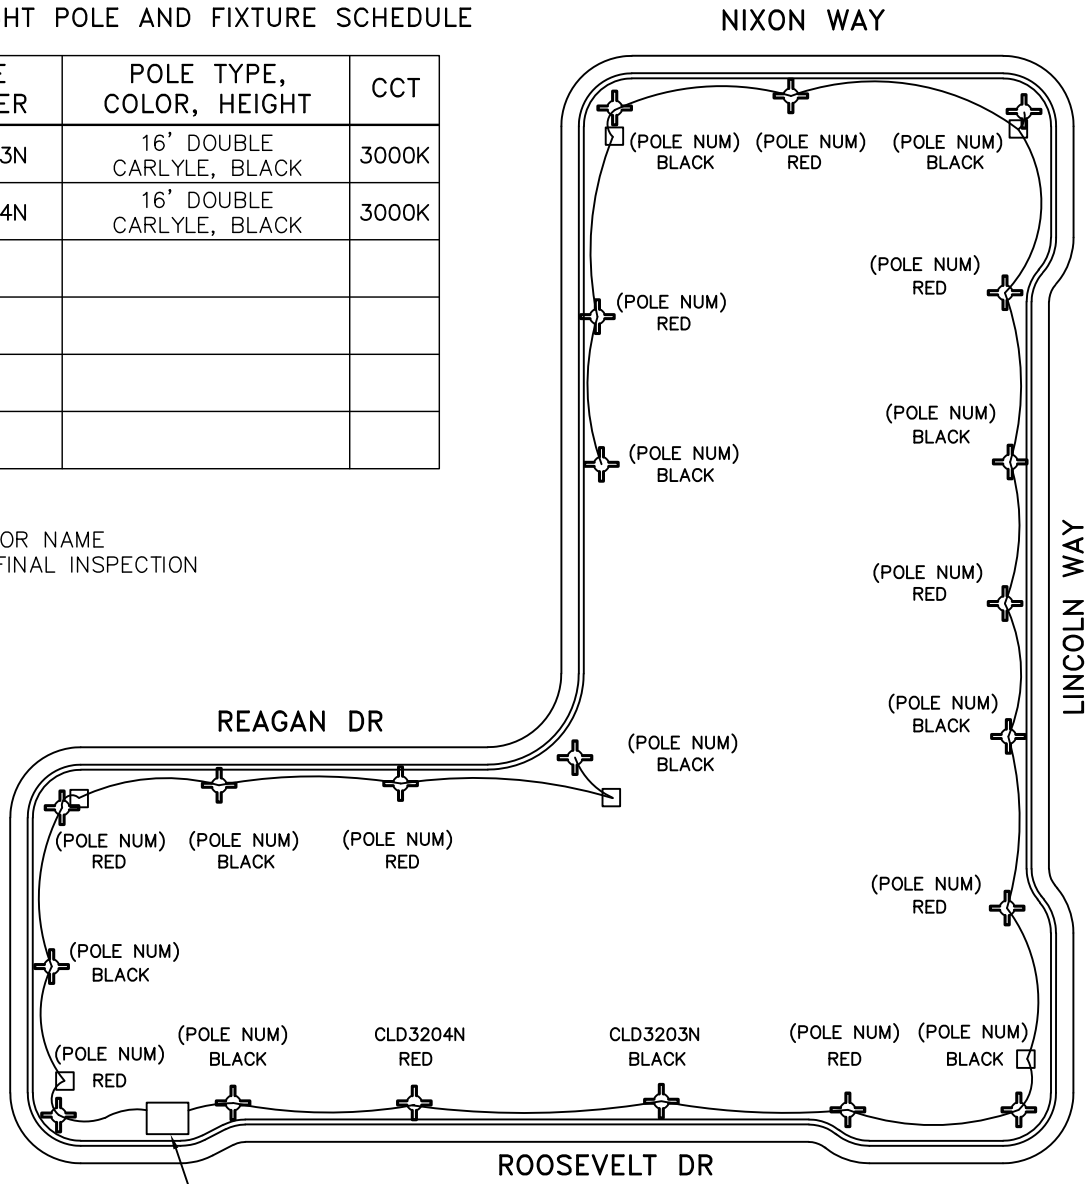

**METER PEDESTAL**  
CIRCUIT BREAKER SIZE  
WIRE SIZE  
METER NUMBER

**LEGEND**

- STREETLIGHT
- POLE NUMBER
- CIRCUIT COLOR CODE
- CONDUIT RUN
- JUNCTION BOX

SKELETON OUTLINE OF STREET LIGHT CIRCUITS SHOULD BE DEVOID OF ALL OTHER INFRASTRUCTURE AND SHOULD ONLY SHOW BASIC STREET GEOMETRY.

**\*NOT TO SCALE**

|                                                                            |                                        |  |
|----------------------------------------------------------------------------|----------------------------------------|--|
| <p>AS-BUILT DRAWING<br/>(TYPICAL)</p>                                      |                                        |  |
|                                                                            | REVISION & DATE                        |  |
| <p>ARLINGTON COUNTY, VIRGINIA<br/>DEPARTMENT OF ENVIRONMENTAL SERVICES</p> | <p>DRAWING NO.<br/><b>14130-01</b></p> |  |